

**KEY:**


- CPZ WR BOUNDARY**
- PARKING BAY TYPES**
- PERMIT
  - PERMIT (SUSPENDED ON EVENT DAYS)
  - PERMIT HOLDERS & PAY BY PHONE(SUSPENDED ON EVENT DAYS)
  - DISABLED BAY
  - BAY TYPES (Footway parking)**
  - PERMIT (2 wheels on Footway Parking)

**GENERAL**


- DOUBLE YELLOW LINES (50mm)
- SINGLE YELLOW LINES (50mm)
- BUS STOP
- DROPPED KERB
- ILLEGAL DROPPED KERB
- CROSSING FACILITY

**STREET FURNITURE**

- LAMP COLUMN
- POST (4m)
- POST (3m)
- POST (1.5m)
- EX POST
- TP

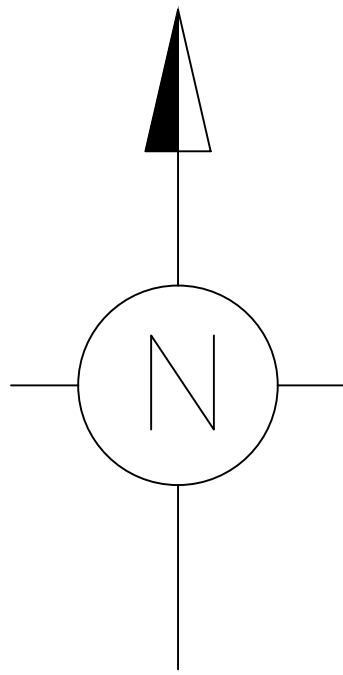

"This map is reproduced from Ordnance Survey material with the permission of the Controller of Her Majesty's Stationery Office ©Crown copyright. Unauthorised reproduction infringes Crown copyright and may lead to prosecution or civil proceedings 100019441 [2020]."

-	-	C.R-W March 2020 DRAWN BY AND DATE	C.R-W March 2020 DESIGNED BY AND DATE	M.P March 2020 CHECKED BY AND DATE	M.T March 2020 APPROVED BY AND DATE
REVISION	AMENDMENT				
 LONDON BOROUGH OF RICHMOND UPON THAMES			DRAFT		N.T.S
			ISSUE		
CLIENT	LONDON BOROUGH OF RICHMOND UPON THAMES				
PROJECT	PARKING WORK PROGRAMME 2019/20				
DRAWING TITLE	CPZ WR – AS BUILT Monday–Saturday 8.30am–6.30pm/Events 11am–11pm				
ISSUING OFFICE	TWICKENHAM	DRAWING NUMBER			REVISION
TELEPHONE	020 88911411	CPZ-WR-1			