


KEY:

- - - - - NEW CPZ BOUNDARY
- NEW PARKING**
- PERMIT PARKING AREA
(NO BAY MARKINGS EXCEPT WHERE SPECIFIC BAYS ARE PROVIDED)(Roads greyed out)
- PERMIT BAY (EXISTING RESIDENTS BAY INCLUDED)
- PERMIT HOLDERS & PAY BY PHONE PARKING BAY
(4 hours no return within 1 hour)
- PAY AND DISPLAY PARKING BAY (1 hours max stay)
- PAY BY PHONE ONLY (2 hours max stay)
- TAXI RANK
- CYCLE PARKING AREA
- Drop off / pick up bays for coaches. Max stay 20 mins
- NEW WAITING RESTRICTIONS**
- DOUBLE YELLOW LINES (50mm)
- EXISTING BAYS**
- CAR CLUB BAY
- DISABLED BAY
- STREET TRADERS PITCH
- LOADING BAY
- MOTORCYCLE BAY
- EXISTING WAITING RESTRICTIONS**
- DOUBLE YELLOW LINES (50mm)
- GENERAL**
- DROPPED KERB
- LAMP COLUMN
- ⊠ FIRE HYDRANT
- EXISTING RED ROUTE
- DOUBLE RED LINES
- SINGLE RED LINE

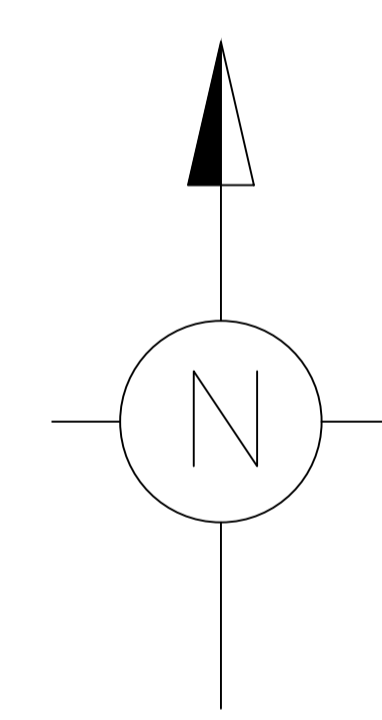

"This map is reproduced from Ordnance Survey material with the permission of the Controller of Her Majesty's Stationery Office © Crown copyright. Unauthorised reproduction infringes Crown copyright and may lead to prosecution or civil proceedings 100019441 [2021]."

REVISION	AMENDMENT	C.R-W May 2021 DRAWN BY AND DATE	C.R-W May 2021 DESIGNED BY AND DATE	M.P May 2021 CHECKED BY AND DATE	M.T May 2021 APPROVED BY AND DATE
			DRAFT	SCALE	
			ISSUE	N.T.S	
CLIENT		LONDON BOROUGH OF RICHMOND UPON THAMES			
PROJECT		CONTROLLED PARKING ZONE			
DRAWING TITLE		CPZ KC AS BUILT (Mon-Sun/10am-4.30pm) & EVENT ZONE (10am-11pm)			
ISSUING OFFICE		DRAWING NUMBER		REVISION	
TELEPHONE 020 88911411		TWICKENHAM CPZ-KC-01		-	